IN THE MATTER OF THE APPLICA- \* TION OF RICHARD J. JOHNSON, ET UX FOR A ZONING VARIANCE ON PROPERTY LOCATED ON THE NORTH SIDE OF FORGE ROAD, REAR 167' WEST OF END 236' ACCESS ROAD, SUCH ROAD BEING \* 220' WEST OF AND OPPOSITE WINKLER ROAD (5216 FORGE ROAD)\*

11TH ELECTION DISTRICT

5TH COUNCILMANIC DISTRICT

COUNTY BOARD OF APPEALS

BALTIMORE COUNTY CASE NO. 90-164-A

#### ORDER OF DISMISSAL

This matter comes before the Poard as an appeal from the decision of the Zoning C. missioner dated November 29, 1989 which denied the subject Petition for Variance on property located in the Eleventh Election District of Baltimore County.

WHEREAS, the Board of Appeals is in receipt of a Letter of Dismissal of appeal filed June 13, 1990 (a copy of which is attached hereto and made a part hereof) from David S. Pearl, Esquire, Counsel for the Appellants in the above-entitled case; and WHEREAS, Mr. Pearl requests that the appeal filed by him on behalf of said Appellants be dismissed and withdrawn as of June 13,

IT IS HEREBY ORDERED this 13th day of June, 1990 by the County Board of Appeals of Baltimore County that said appeal be and the same is hereby DISMISSED.

COUNTY BOARD OF APPEALS OF BALTIMORE COUNTY William T. Wacket William T. Hackett, Chairman . Buchheister, Jr

GERSHBERG AND PEARL ATTORNEYS AT LAW SUITE 702 TITLE BUILDING

110 St. PAUL STREET BALTINORE, MARYLAND 21202-1748 (301) 837-2850 FAX: (301) 837-2591

RICHARD L. GERSHBERG\* DAVID S. PEARL June 12, 1990 DENNIS R. SOBER\*\* JUDITE C. TODES"

NOITARDINNI WADIRENA BERNEM LAWYERS ASSN. WASHINGTON, D.C. WI GETTINGS ORLASS

The County Board of Apreals for Baltimore County County Office Building 111 W. Chesapeake Avenue Towson, Maryland 21204

> Re: Case No.: 90-164-A Richard J. Johnson, et ux. N/s Forge Road, rear 167' W of end of 235' access road, such road being 220' W of & opposite Winkler Road (5216 Forge Road)
> 11th Election District; 5th Councilmanic District

VAR - to allow pool in front yard in lieu of rear yard.

11/29/89 - %.C.'s Order Denying Petition

#### Gentlemen:

SCOTT M. SHERLOCE

Please be advised that my clients, Mr. and Mrs. Richard Johnson do hereby wish to dismiss their appeal. They may plan, however, to refile the zoning variance in a couple of years.

Please advise whether there are any outstanding costs or other information that you may need to effectuate the dismissal.

Very truly yours,

DSP:gcl pc: Mr. and Mrs. Richard Johnson 1532L-12.2

#29

Anderson v. Bd. of Appeals, Town of Chesapeake Beach, 22 Md. App. 28 (1974).

In reviewing the evidence, there is insufficient evidence to allow a finding that the Petitioner would experience practical difficulty or unreasonable hardship if the requested variance was denied. The testimony presented by the Petitioner was in support of a matter of a preference rather than of the necessity for the variance. The Petitioner has failed to show that compliance would unreasonably prevent the use of the property or be unnecessarily burdensome. Therefore, the variance requested must be

Pursuant to the advertisement, posting of the property, and public hearing on this Petition held, and for the reasons given above, the relief requested should be denied.

THEREFORE, IT, IS ORDERED by the Zoning Commissioner for Baltimore day of forumlar, 1989 that the Petition for a Variance to allow an accessory structure (swimming pool) to be located in the front yard in lieu of the required rear yard, be and is hereby DENIED.

> Zoning Commissioner for Baltimore County

cc: Peoples Counsel

ZONING DESCRIPTION

Lot #2 in the subdivision of the Patrick L. Donovan property. Liber S.M. 57, Folio 118. Also known as 5216 Forge Road, Perry Hall, in the 11th Election District, 4th Precinct.

IN RE: PETITION FOR ZONING VARIANCE NS Forge Rd., rear 167' west of \* ZONING COMMISSIONER end 236'access road, such road being 220' west of and opposite Winkler Road (5216 Forge Road) \* OF BALTIMORE COUNTY 5th Councilmanic District \* Case No. 90-164-A 11th Election District Richard J. Johnson, et ux

Petitioners

#### FINDINGS OF FACT AND CONCLUSIONS OF LAW

\* \* \* \* \* \* \* \* \* \*

The Petitioners herein request a variance from Section 400.1 to allow an accessory structure (swimming pool) to be located in the front yard in lieu of the required rear yard, as more particularly described on Petitioners' Exhibit 1.

The Petitioners, Mr. and Mrs. Johnson, did not appear. Mr. J.A. Arkuszeski, Jr., of Aries Builders, appeared and testified on behalf of the Petitioners. Mr. B. Rain, 5216A Forge Road, Perry Hall, and Mr. P. Snedegar, appeared as Protestants.

Testimony indicated that a new home has been built on lot No. 2, shown on Petitioners' Exhibit 1, in the location shown for the home on that exhibit. The home was constructed in the past two years in such a manner as to place the majority of the available open lot in the front yard of this property. The Petitioners have now requested that a swimming pool be constructed on this site. They want it in the front yard, due to the topography of the land.

The Protestants argue that the construction of this pool is inconsistent with the zoning regulations and that if any hardship has been created, by the placement of this pool in the front yard, the creation of that

hardship is a result of the Petitioners own actions in placing the home too far to the rear of the lot and occupying the large percentage of the land in the rear yard.

The evidence overwhelmingly establishes that the Petitioners have created this hardship for themselves. The Petitioners contracted to have the subject house built upon the subject lot which is, clearly, large enough to accommodate a swimming pool and a house. A short time after the subject home was constructed, the Petitioners are now desirous of placing an accessory structure, namely, a swimming pool on the lot in a position that is in absolute contradiction with the Baltimore County ning Regulations (B.C.Z.R).

Clearly, the Petitioner created the situation that exists today upon this lot and the hardship and practical difficulty, if any, has been solely created by the actions and behavior of the Petitioner.

An area variance may be granted where strict application of the zoning regulations would cause practical difficulty to the Petitioner and his property. McLean v. Soley, 270 Md. 208 (1973). To prove practical difficulty for an area variance, the Petitioner must meet the following:

> 1) whether strict compliance with requirement would unreasonably prevent the use of the property for a permitted purpose or render conformance unnecessarily burdensome;

2) whether the grant would do substantial injustice to applicant as well as other property owners in the district or whether a lesser relaxation than that applied for would give substantial relief; and

whether relief can be granted in such fashion that the spirit of the ordinance will be observed and public safety and welfare secured.

PETITION FOR ZONING VARIANCE

TO THE ZONING COMMISSIONER OF BALTIMORE COUNTY: The undersigned, legal owner(s) of the property situate in Baltimore County and which is described in the description and plat attached hereto and made a part hereof, hereby petition for a Variance from Section \_400.1

\_\_To\_allow\_an\_accessory\_structure\_(swimming\_pool)\_to\_he\_located\_\_ in the front ward in lieu of the required rear yard.

of the Zoning Regulations of Baltimore County, to the Zoning Law of Baltimore County; for the AF NEII following reasons: (indicate hardship or practical difficulty) Due to the sloping grade, it would be difficult, if not impossible, to construct a pool elsewhere on the property. 2. the zoning regulation in question f. did not, we feel, consider "panhandle lots" such as this. 3.A variance from this regulation would still observe the spirit of the regulation without

jeopardizing public welfare or safety. 1000 ×

Property is to be posted and advertised as prescribed by Zoning Regulations.

I, or we, agree to pay expenses of above Variance advertising, posting, etc., upon filing of this petition, and further agree to and are to be bound by the zoning regulations and restrictions of Baltimore County adopted pursuant to the Zoning Law For Baltimore County. I/We do solemnly declare and affirm,

under the penalties of perjury, that I/we are the legal owner(s) of the property which is the subject of this Petition. Legal Owner(s):

Contract Purchaser: (Type or Print Name) (Type or Print Name) Helen 1. Johnson City and State Attorney for Petitioner:

5216 FURGE FD. PERRY How, Mo. 31142 Name, address and phone number of legal owner, contract purchaser or representative to be contacted

J.A.Arkuszeski, Jr. 1131 Engelberth Rd. Balto. 21221 ORDERED By The Zoning Commissioner of Baltimore County, this \_\_\_\_\_ day

AVAILABLE FOR HEARING MON./TUES./WED. - NEXT TWO MONTHS

IN THE MATTER OF THE APPLICA- \* TION OF RICHARD J. JOHNSON COUNTY BOARD OF APPEALS ET UX FOR A ZONING VARIANCE ON PROPERTY LOCATED ON THE NORTH SIDE OF FORGE ROAD, REAR 167' WEST OF END 236' BALTIMORE COUNTY ACCESS ROAD, SUCH ROAD BEING 220' WEST OF AND OPPOSITE CASE NO. 90-164-A WINKLER ROAD (5216 FORGE ROAD)\* 11TH ELECTION DISTRICT 5TH COUNCILMANIC DISTRICT

### ORDER OF DISMISSAL

This matter comes before the Board as an appeal from the decision of the Zoning Commissioner dated November 29, 1989 which denied the subject Petition for Variance on property located in the Eleventh Election District of Baltimore County.

WHEREAS, the Board of Appeals is in receipt of a Letter of Dismissal of appeal filed June 13, 1990 (a copy of which is attached hereto and made a part hereof) from David S. Pearl, Esquire, Counsel for the Appellants in the above-entitled case; and WHEREAS, Mr. Pearl requests that the appeal filed by him on behalf of said Appellants be dismissed and withdrawn as of June 13,

IT IS HEREBY ORDERED this 13th day of June , 1990 by the County Board of Appeals of Baltimore County that said appeal be and the same is hereby DISMISSED.

COUNTY BOARD OF APPEALS OF BALTIMORE COUNTY Oillion Thacket William T. Hackett, Chairman

GERSHBERG AND PEARL ATTORKETS AT LAW Seite 708 Title Building 110 St. PAUL STREET BALTINORE, MARYLAND B1202-1746 (301) 837-8620 FAR: (301) 837-2591

RICHARD L GENEROS DAVID E. PEARL DENNIS R. SORERS JUDITH C. TODES'
SCOTT M. SHERLOCK

June 12, 1990

·Nemato Angeles intermetter LAWYERS ASSN. WARMINGTON, D.C. \*\*ALDO ADMITTED IX WASHINGTON, D.C.

The County Board of Appeals for Baltimore County County Office Building 111 W. Chesapeake Avenue Towson, Maryland 21204

> Richard J. Johnson, \*t ux.
>
> N/s Forge Road, rezr 167' W of end of 235' access
>
> road, such road being 220' W of & opposite Winkler Road (5216 Forge Road)
> 11th Election District; 5th Councilmanic District

VAR - to allow pool in front yard in lieu of rear yard.

11/29/89 - Z.C.'s Order Denying Petition

Gentlemen:

1532L-12.2

Please be advised that my clients, Mr. and Mrs. Richard Johnson do hereby wish to dismiss their appeal. They may plan, however, to refile the zoning variance in a couple of years.

Please advise whether there are any outstanding costs or other information that you may need to effectuate the dismissal.

Very truly yours,

pc: Mr. and Mrs. Richard Johnson

AI :IIMA EI MUL DE



County Moard of Appeals of Maltimore County COUNTY OFFICE BUILDING, ROOM 315 111 W. CHESAPEAKE AVENUE TOWSON, MARYLAND 21204 (301) 887-3180

June 13, 1990

David S. Paarl, Esquire Gershberg and Pearl Suite 702 Title Building 110 St. Paul Street Baltimore, Maryland 21202-1748

Re: Case No. 90 .64-A (Richard J. Johnson, et ux)

Dear Mr. Pearl:

Enclosed please find a copy of the Order of Dismissal issued this date by the County Board of Appeals of Baltimore County

in the subject matter.

Sincerely, LindaLee M. Kuszmaul Legal Secretary

Enclosure

cc: Mr. and Mrs. Richard Johnson Mr. Barry Rider

P. David Fields Pat Keller J. Robert Haines Ann M. Nastarowicz James E. Dyer W. Carl Richards, Jr. Docket Clerk - Zoning Arnold Jablon, County Attorney



County Board of Appeals of Baltimore County COUNTY OFFICE BUILDING

111 W. CHESAPEAKE AVENUE TOWSON, MARYLAND 21204 (301) **EXCEPT** 887-3180 February 9, 1990

NOTICE OF ASSIGNMENT

NO POSTPONEMENTS WILL BE GRANTED WITHOUT GOOD AND SUFFICIENT REASONS. REQUESTS FOR POSTPONEMENTS MUST BE IN WRITING AND IN STRICT COMPLIANCE WITH BOARD RULE 2(b). NO POSTPONEMENTS WILL BE GRANTED WITHIN FIFTEEN (15) DAYS OF SCHEDULED HEARING DATE UNLESS IN FULL COMPLIANCE WITH RULE 2(c), COUNTY COUNCIL

BILL NO. 59-79.

CASE NO. 90-164-A RICHARD J. JOHNSON, ET UX N/s Forge Rd., rear 167' W of end 236' access road, such road being 220' W of & opposite Winkler Rd. (5216 Forge Rd.)

11th Election District; 5th Councilmanic District VAR -to allow pool in front yard in lieu of rear yard.

11, 3/89 - Z.C.'s Order DENYING Petition.

FRIDAY, JULY 13, 1990 at 10:00 a.m. ASSIGNED FOR: cc: David S. Pearl, Esquire Counsel for Petitioners/Appellants

Mr. and Mrs. Richard Johnson Mr. Barry Rider

P. David Fields Pat Keller J. Robert Haines

Ann M. Nastarowicz James E. Dyer W. Carl Richards, Jr. Docket Clerk - Zoning

Arnold Jablon, County Attorney

LindaLee M. Kuszmaul Legal Secretary



County Board of Appeals of Baltimore County

COUNTY OFFICE BUILDING 111 W. CHESAPEAKE AVENUE TOWSON, MARYLAND 21204 Room 301, County Office Bldg. (301) EDITEST 887-3180 February 9, 1990

NOTICE OF ASSIGNMENT

NO POSTFONEMENTS WILL BE GRANTED WITHOUT GOOD AND SUFFICIENT REASONS. REQUESTS FOR POSTFONEMENTS MUST BE IN WRITING AND IN STRICT COMPLIANCE WITH BOARD RULE 2(b). NO POSTPONEMENTS WILL BE GRANTED WITHIN FIFTEEN (15) DAYS OF SCHEDULED HEARING DATE UNLESS IN FULL COMPLIANCE WITH RULE 2(c), COUNTY COUNCIL BILL NO. 59-79.

CASE NO. 90-164-A RICHARD J. JOHNSON, ET UX N/s Forge Rd., rear 167' W of end 236' access

road, such road being 220' W of & opposite Winkler Rd. (5216 Forge Rd.) 11th Election District; 5th Councilmanic District VAR -to allow pool in front yard in lieu of rear yard.

11/29/89 - Z.C.'s Order DENYING Petition.

FRIDAY, JULY 13, 1990 at 10:00 a.m.

cc: David S. Pearl, Esquire Counsel for Petitioners/Appellants Mr. and Mrs. Richard Johnson

Mr. Barry Rider People's Counsel for Baltimore County P. David Fields

Pat Keller J. Robert Haines Ann M. Nastarowicz James E. Dyer

W. Carl Richards. Jr. Docket Clerk - Zoning Arnold Jablon, County Attorney



LindaLee M. Kuszmaul Legal Secretary

2/9/90 - Following parties notified of hearing set for Fri., July 13, 1990 at 10:00 a.m.: David S. Pearl, Esquire

Mr. & Mrs. Richard Johnson Mr. Parry Rider People's Counsel P. David Fields Pat Keller J. Robert Haines Ann M. Nastarowicz James E. Dyer W. Carl Richards, Jr. Docket Clerk - Zoning Arnold Jablon

5/21/90

Received T/C from gentleman regarding Case No. 90-164-A -sign posted in front of 734 Wampler Road. This sign should have been located at 5216 Forge Road (Richard Johnson, et ux); had originally been posted in January 1990; reposted 5/18/90; telephoned He will verify that 5216 Forge Road is still posted; and will also ride past 734 Wampler Road; if sign is

Baltimore County Zoning Commissioner Office of Planning & Zoning Towson, Maryland 21204 (301) 887-3353 J. Robert Haines
Zoning Commissioner

January 8, 1990



Baltimore County Board of Appeals County Office Building, Room 315 Towson, Maryland 21204

RE: Petition for Zoning Variance NS Forge Rd., rear 167' west of enc 236' access road, such road being 220' west of and opposite Winkler Road (5216 Forge Road) 11th Election District, 5th Councilmanic District Richard J. Johnson, et ux - Petitioner

Case No. 90-164-A

Please be advised that an appeal of the above referenced case was filed in this office on December 18, 1989 by David S. Pearl, Esquire. All materials relative to the case are being forwarded herewith.

Please notify all parties to the case of the date and time of the appeal hearing when it has been scheduled. If you have any questions concerning this matter, please do not hesitate to contact this office.

Zoning Commissioner

JRH: jat

Dear Board:

cc: David S. Pearl, Esquire, 110 St. Paul St., Balto., Md. 21202-1748 Richard R. Johnson, et ux, 5216 Forge Road, Perry Hall, Md. 21143 Barry Rider, 7813 Beverly Avenue, Balto., Md. 21234 People's Counsel of Baltimore County Rm. 304, County Office Bldg., Towson, Md. 21204

GERSHBERG AND PEARL ATTORNEYS AT LAW SUITE 702 TITLE BUILDING

110 St. Paul Street BALTINORE, MARYLAND 21202-1748 (301) 837-2850

FAX: (301) 837-2591

RICHARD L GERSHBERO DAVID S. PEARL JUDITH C. TODES" SCOTT M. SHENLOCK

DSP:cmg

December 12, 1989

Mr. J. Robert Haines Baltimore County Zoning Commissioner, Office of Planning And Zoning Towson, Maryland 21204

RE: Mr. and Mrs. Richard R. Johnson

Dear Mr. Haines:


Please be advised that this office was retained by Mr. and Mrs. Richard R. Johnson with reference to your denial of their petition for zoning variance, Case No. 90-164-\$4.

Kindly be advised that it is the intention of Mr. and Mrs. Richard R. Johnson to appeal your decision.


Enclosed therefore, please find a check made payable to Baltimore County Maryland in the amount of \$150.00 covering the appeal fee.

If other documentation or forms are required, please forward them to my office immediately. Thank you for your kind attention to this matter.

Very truly yours,

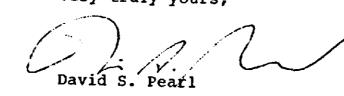


Enclosure cc. Richard R. Johnson 0458L-1.2

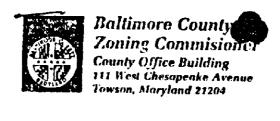

1/10/90

APPEAL FEES

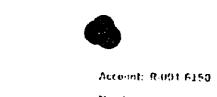

A CHARLES

11/1/1

140 -OF ALL OTHER ORDERS 150 -POSTING SIGNS / ADVERTISHED )

HOME STANCE LAST NAME OF OWNERS JOHNSON

B | B | C | H + \* \* \* 15 | P | P | 15 | 16 | 7 Please make checks payable to: Paltiniore County

MEHBER AHERICAN IMMIORATION

LAWYERS ASSN. WASHINGTON, D.C.

Baltimore County
Zoning Commissioner
Office of Planning & Zoning Towson, Maryland 21204 (301) 887-3353 J. Robert Haines

November 24, 1989



Hr. and Hrs. Richard R. Johnson 5216 Forge Road Perry Hall, Maryland 21143

RE: Petition for Zoning Variance Case No. 90-164-A

Dear Mr. and Mrs. Hughes:

Enclosed please find the decision rendered in the above captioned case. The Petition for Zoning Variance has been denied, in accordance with the attached Order.

In the event the decision rendered is unfavorable to any party. please be advised that any party may file an appeal within thirty (30) days of the date of the Order to the County Board of Appeals. If you require additional information concerning filing an appeal, please feel free to contact our Appeals Clerk at 887-3391.

Zoning Commissioner

cc: Peoples Counsel

GERSHBERG AND PEARL ATTORNEYS AT LAW SUITE 702 TITLE BUILDING 110 St. PAUL STREET BALTIMORE, MARYLAND 21202-1748 (301) 837-2850

Fax: (301) 837-2591

RICHARD L. GERSHBERG DAVID S. PEARL JUDITH C. TODES\* SCOTT M. SHERLOCK

\*MEMBER AMERICAN INNIGRATION

LAWYERS ASSN. WASHINGTON, D.C.

December 12, 1989

Mr. J. Robert Haines Baltimore County Zoning Commissioner, Office of Planning And Zoning Towson, Maryland 21204

RE: Mr. and Mrs. Richard R. Johnson

Dear Mr. Haines:

Please be advised that this office was retained by Mr. and Mrs. Richard R. Johnson with reference to your denial of their petition for zoning variance, Case No. 90-164-44.

Kindly be advised that it is the intention of Mr. and Mrs. Richard R. Johnson to appeal your decision.

Enclosed therefore, please find a check made payable to Baltimore County Maryland in the amount of \$150.00 covering the

If other documentation or forms are required, please forward them to my office immediately. Thank you for your kind attention to this matter.

Very truly yours,

DSP:cmg Enclosure cc. Richard R. Johnson 0458L-1.2

PETITION FOR ZONING VARIANCE TO THE ZONING COMMISSIONER OF BALTIMORE COUNTY:

The undersigned, legal owner(s) of the property situate in Baltimore County and which is described in the description and plat attached hereto and made a part hereof, hereby petition for a ... alloy an accessory etructure laxianing pooll is be located... in the front yerd in lieu of the required rear yard.

of the Zoning Regulations of Baltimore County, to the Zoning Law of Baltimore County; for the following reasons: (indicate hardship or practical difficulty) Due to the sloping grade, it would be difficult, if not impossible, to construct a pool elsewhere on the property. 2. the zoning regulation in question did not, we feel, consider "panhandle lots" such as this. 3.A variance from this regulation would still observe the spirit of the regulation without jeopardizing public welfare or safety.

Property is to be posted and advertised as prescribed by Zoning Regulations.

I, or we, agree to pay expenses of above Variance advertising, posting, etc., upon filing of this petition, and further agree to and are to be bound by the zoning regulations and restrictions of Baltimore County adopted pursuant to the Zoning Law For Baltimore County.

I/We do solemnly declare and affirm, under the penalties of perjury, that I/we are the legal owner(s) of the property which is the subject of this Petition.

X +279

Legal Owner(s): Contract Purchaser: Richard J. Johnson. (Type or Print Name) (Type or Print Name) Ablew R. Johnson City and State Attorney for Petitioner: (Type or Print Name) Name, address and phone number of legal owner, contract purchaser or representative to be contacted J.A.Arkuszeski, Jr. 1131 Engelberth Rd. Balto. 21221 City and State Attorney's Telephone No.: ORDERED By The Zoning Commissioner of Baltimore County, this \_\_\_\_\_ day 19-82, that the subject matter of this petition be advertised, as required by the Zoning Law of Baltimore County, in two newspapers of general circulation throughout Baltimore County, that property be posted, and that the public hearing be had before the Zoning out Baltimore County, that property be posted, and that the public hearing be had before the Zoning Commissioner of Baltimore County in Room 106, County Office Building in Towson, Baltimore

Baltimore County Zoning Commissioner Office of Planning & Zoning Towson, Maryland 21204 (301) 887-3353 J. Robert Haines
Zoning Commissioner

November 24, 1989



Mr. and Mrs. Richard R. Johnson 5216 Forge Road Perry Hall, Maryland 21143

RE: Petition for Zoning Variance Case No. 90-164-A

Dear Mr. and Mrs. Hughes:

Enclosed please find the decision rendered in the above captioned case. The Petition for Zoning Variance has been denied, in accordance with the attached Order.

In the event the decision rendered is unfavorable to any party, please be advised that any party may file an appeal within thirty (30) days of the date of the Order to the County Board of Appeals. If you require additional information concerning filing an appeal, please feel free to contact our Appeals Clerk at 887-3391.

cc: Peoples Counsel

ZONING DESCRIPTION

Lot #2 in the subdivision of the Patrick L. Donovan property. Liber S.M. 57, Folio 118. Also known as 5216 Forge Road, Perry Hall, in the 11th Election District, 4th Precinct.

Baltimore County Zoning Commissioner Office of Planning & Zoning Towson, Maryland 21204 (301) 887-3353

J. Robert Haines Zoning Commissioner

Baltimore County Board of Appeals County Office Building, Room 315 Towson, Maryland 21204

RE: Petition for Zoning Variance NS Forge Rd., rear 167' west of enc 236' access moad, such road being 220' west of and opposite Winkler Road (5216 Forge Road) 11th Election District, 5th Councilmanic District Richard J. Johnson, et ux - Petitioner Case No. 90-164-A

Dear Board:

Please be advised that an appeal of the above-referenced case was filed in this office on December 18, 1989 by David S. Pearl, Esquire. All materials relative to the case are being forwarded

Please notify all parties to the case of the date and time of the appeal hearing when it has been scheduled. If you have any questions concerning this matter, please do not hesitate to contact this office.

J. ROBERT HAINES

Zoning Commissioner

January 8, 1990

JRH: jat

cc: David S. Pearl, Esquire, 110 St. Paul St., Balto., Md. 21202-1748 Richard R. Johnson, et ux, 5216 Forge Road, Perry Hall, Md. 21143 Barry Rider, 7813 Beverly Avenue, Balto., Md. 21234 People's Counsel of Baltimore County Rm. 304, County Office Bldg., Towson, Md. 21204

Petition for Zoning Variance N/S Foprge Rd., rear 167' west of end 236' access road, such roac heing 220' west of and opposite Winkler Road (5216 Forge Road) 5th Councilmanic District - 11th Election District RICHARD J. JOHNSON, ET UX - Petitioners Case No. 90-164-A

Petition for Zoning Variance

Description of Property

Certificate of Posting

Certificate of Publication

Zoning Plans Advisory Committee Comments

Director of Planning & Zoning Comments, dated October 31, 1989

Petitioner's Exhibit: 1. Plat for Zoning Variance

Protestant's Exhibits: 1 thru 6 - Plats describing different pools and 2 pages - 4 pictures of site

Zoning Commissioner's Order, dated November 29, 1989

Notice of Appeal received December 18, 1989

List all Names of parties involved

David S. Pearl, Esquire, 110 St. Paul St., Balto., Md. 21202-1748 Richard R. Johnson, et ux, 5126 Forge Road, Perry Hall, Md. 21143 Barry Rider, 7813 Beverly Avenue, Balto., Md. 21234

People's Counsel of Baltimore County Rm. 304, County Office Bldg., Towson, Md. 21204

Request Notification: P. David Fields, Director of Planning & Zoning Patrick Keller, Office of Planning & Zoning J. Robert Haines, Zoning Commissioner Ann M. Nastarowicz, Deputy Zoning Commissioner James E. Dyer, Zoning Supervisor W. Carl Richards, Jr., Zoning Coordinator Docket Clerk Arnold Jablon, County Attorney

County Board of Appeals of Baltimore County

HEARING ROOM -Room 301, County Office Bldg.

COUNTY OFFICE BUILDING 111 W. CHESAPEAKE AVENUE TOWSON, MARYLAND 21204 (301) 2020/2020 887-3180

February 9, 1990 NOTICE OF ASSIGNMENT

NO POSTPONEMENTS WILL BE GRANTED WITHOUT GOOD AND SUFFICIENT REASONS. REQUESTS FOR POSTPONEMENTS MUST BE IN WRITING AND IN STRICT COMPLIANCE WITH BOARD RULE 2(b). NO POSTPONEMENTS WILL BE GRANTED WITHIN FIFTEEN (15) DAYS OF SCHEDULED HEARING DATE UNLESS IN FULL COMPLIANCE WITH RULE 2(c), COUNTY COUNCIL

BILL NO. 59-79. CASE NO. 90-164-A RICHARD J. JOHNSON, ET UX N/s Forge Rd., rear 167' W of end 236' access road, such road being 220' W of & opposite Winkler Rd. (5216 Forge Rd.)

> VAR -to allow pool in front yard in lieu of rear yard.

11th Election District; 5th Councilmanic District

11/29/89 - Z.C.'s Order DENYING Petition.

FRIDAY, JULY 13, 1990 at 10:00 a.m. ASSIGNED FOR:

Counsel for Febitioners/Appellants cc: David S. Pearl, Esquire Mr. and Mrs. Richard Johnson

Mr. Barry Rider People's Counsel for Baltimore County P. David Fields Pat Keller J. Robert Haines Ann M. Nastarowicz James E. Dyer ,W. Carl Richards, Jr. √Docket Clerk - Zoning

Arnold Jablon, County Attorney

LindaLee M. Kuszmaul Legal Secretary

Baltimore County Zoning Commissioner Office of Planning & Zoning Towson, Maryland 21204 (301) 887-3353 J. Robert Haines Zoning Commissioner

Nover. 6: 24, 1989



Dennis F. Rasmussen
County Executive

Mr. and Mrs. Richard R. Johnson 5216 Forge Road Perry Hall, Maryland 21143

RE: Petition for Zonir ' Variance Case No. 90-164-A

Dear Mr. and Mrs. Hughes:

Enclosed please find the decision rendered in the above captioned case. The Petition for Zoning Variance has been denied, in accordance with the attached Order.

In the event the decision rendered is unfavorable to any party, please be advised that any party may file an appeal within thirty (30) days of the date of the Order to the County Board of Appeals. If you require additional information concerning filing an appeal, please feel free to contact our Appeals Clerk at 887-3391.

// Zoning Commissioner

cc: Peoples Counsel

GERSHBERG AND PEARL ATTORNEYS AT LAW SUITE 702 TITLE BUILDING 110 St. PAUL STREET BALTIMORE, MARYLAND 21202-1748 (301) 837-2850 FAX: (301) 837-2591

RICHARD L GERSHBERG December 12, 1989 DAVID S. PEARL JUDITH C. TODES\* SCOTT M. SHERLOCK

> Mr. J. Robert Haines Baltimore County Zoning Commissioner, Office of Planning And Zoning Towson, Maryland 21204

RE: Mr. and Mrs. Richard R. Johnson

Dear Mr. Haines:

Please be advised that this office was retained by Mr. and Mrs. Richard R. Johnson with reference to your denial of their petition for zoning variance, Case No. 90-164-44.

Kindly be advised that it is the intention of Mr. and Mrs. Richard R. Johnson to appeal your decision.

Enclosed therefore, please find a check made payable to Baltimore County Maryland in the amount of \$150.00 covering the appeal fee.

If other documentation or forms are required, please forward them to my office immediately. Thank you for your kind attention to this matter.

Very truly yours,

Enclosure cc. Richard R. Johnson 0458L-1.2

LAWYERS ASSN. WASHINGTON, D.C.

PETITION FOR ZONING VARIANCE

TO THE ZONING COMMISSIONER OF BALTIMORE COUNTY: The undersigned, legal owner(s) of the property situate in Baltimore County and which is described in the description and plat attached hereto and made a part hereof, hereby petition for a

Variance from Section 400.1 To allow an accessory structure lawinming pooll to be located. in the front yard in lieu of the required rear yard.

of the Zoning Regulations of Baltimore County, to the Zoning Law of Baltimore County; for the following reasons: (indicate hardship or practical difficulty) Due to the sloping grade, it would be difficult, if not impossible, to construct a pool elsewhere on the property. 2. the zoning regulation in question did not, we feel, consider "panhandle lots" such as this. 3.A variance from this regulation would 'ill observe the spirit of the regulation without jeopardizing public welfare or safety.

Property is to be posted and advertised as prescribed by Zoning Regulations.

I, or we, agree to pay expenses of above Variance advertising, posting, etc., upon filing of this petition, and further agree to and are to be bound by the zoning regulations and restrictions of Baltimore County adopted pursuant to the Zoning Law For Baltimore County.

I/We do solemnly declare and affirm, under the penalties of perjury, that I/we are the legal owner(s) of the property which is the subject of this Petition. Legal Owner(s): Contract Purchaser: Richard J. Johnson. (Type or Print Name) Helen R. Johnson (Type or Print Name) Holew R. Johnson City and State Attorney for Petitioner: Name, address and phone number of legal owner, contract purchaser or representative to be contacted J.A.Arkuszeski, Jr. 

ORDERED By The Zoning Commissioner of Baltimore County, this \_\_\_\_\_ day 19\_82, that the subject atter of this petition be advertised, as required by the Zoning Law of Baltimore County, in two newspapers of general circulation throughout Baltimore County, that property be posted, and that the public hearing be had before the Zoning out Baltimore County, that property be posted, and that the public hearing be had before the Zoning Commissioner of Baltimore County in Room 106, County Office Building in Towson, Baltimore

Baltimore County Zoning Commissioner Office of Planning & Zoning Towson, Maryland 21204 (301) 887-3353 J. Robert Haines



Mr. and Mrs. Richard R. Johnson 5216 Forge Road Perry Hall, Maryland 21143

> RE: Petition for Zoning Variance Case No. 90-164-A

Dear Mr. and Mrs. Hughes:

Enclosed please find the decision rendered in the above captioned case. The Petition for Zoning Variance has been denied, in accordance with the attached Order.

In the event the decision rendered is unfavorable to any party, please be advised that any party may file an appeal within thirty (30) days of the date of the Order to the County Board of Appeals. If you require additional information concerning filing an appeal, please feel free to contact our Appeals Clerk at 387-3391.

Zoning Commissioner

cc: Peoples Counsel

ZONING DESCRIPTION

Lot #2 in the subdivision of the Patrick L. Donovan property. Liber S.M. 57, Folio 118. Also known as 5216 Forge Road, Perry Hall, in the 11th Election District, 4th Precinct.

Baltimore County Zoning Commissioner Office of Planning & Zoning Towson, Maryland 21204 (301) 887-3353

J. Robert Haines

January 8, 1990



Baltimore County Board of Appeals County Office Building, Room 315 Towson, Maryland 21204

RE: Petition for Zoning Variance NS Forge Rd., rear 167' west of enc 236' access road, such road being 220' west of and opposite Winkler Road (5216 Forge Road) 11th Election District, 5th Councilmanic District Richard J. Johnson, et ux - Petitioner Case No. 90-164-A

Dear Board:

Please be advised that an appeal of the above-referenced case was filed in this office on December 18, 1989 by David S. Pearl, Esquire. All materials relative to the case are being forwarded herewith.

Please notify all parties to the case of the date and time of the appeal hearing when it has been scheduled. If you have any questions concerning this matter, please do not hesitate to contact this office.

Zoning Commissioner

cc: David S. Pearl, Esquire, 110 St. Paul St., Balto., Md. 21202-1748 Richard R. Johnson, et ux, 5216 Forge Road, Perry Hall, Md. 21143 Barry Rider, 7813 Beverly Avenue, Balto., Md. 21234 People's Counsel of Baltimore County Rm. 304, County Office Bldg., Towson, Md. 21204

Petition for Zoning Variance N/S Foprge Rd., rear 167' west of end 236' access road, such roac being 220' west of and opposite Winkler Road (5216 Forge Road) 5th Councilmanic District - 11th Election District RICHARD J. JOHNSON, ET UX - Petitioners Case No. 90-164-A

Petition for Zoning Variance

Description of Property Certificate of Posting

Certificate of Publication

Zoning Plans Advisory Committee Comments

Director of Planning & Zoning Comments, dated October 31, 1989

Petitioner's Exhibit: 1. Plat for Zoning Variance

Protestant's Exhibits: 1 thru 6 - Plats describing different pools and 2 pages - 4 pictures of site

Zoning Commissioner's Order, dated November 29, 1989

Notice of Appeal received December 18, 1989 List all Names of parties involved

David S. Pearl, Esquire, 110 St. Paul St., Balto., Md. 21202-1748 Richard R. Johnson, et ux, 5126 Forge Road, Perry Hall, Md. 21143 Barry Rider, 7813 Beverly Avenue, Balto., Md. 21234

People's Counsel of Baltimore County Rm. 304, County Office Bldg., Towson, Md. 21204

Request Notification: P. David Fields, Director of Planning & Zoning Patrick Keller, Office of Planning & Zoning J. Robert Haines, Zoning Commissioner Ann M. Nastarowicz, Deputy Zoning Commissioner James E. Dyer, Zoning Supervisor W. Carl Richards, Jr., Zoning Coordinator Docket Clerk Arnold Jablon, County Attorney

County Board of Appeals of Paltimore County

COUNTY OFFICE BUILDING

HEARING ROOM -Room 301, County Office Bldg. 111 W. CHESAPEAKE AVENUE TOWSON, MARYLAND 21204 

February 9, 1990 NOTICE OF ASSIGNMENT

NO POSTPONEMENTS WILL BE GRANTED WITHOUT GOOD AND SUFFICIENT REASONS. REQUESTS FOR POSTPONEMENTS MUST BE IN WRITING AND IN STRICT COMPLIANCE WITH BOARD RULE 2(b). NO POSTPONEMENTS WILL BE GRANTED WITHIN FIFTEEN (15) DAYS OF SCHEDULED HEARING DATE UNLESS IN FULL COMPLIANCE WITH RULE 2(c), COUNTY COUNCIL BILL NO. 59-79.

CASE NO. 90-164-A RICHARD J. JOHNSON, ET UX N/s Forge Rd., rear 167' W of end 236' access road, such road being 220' W of & opposite Winkler Rd. (5216 Forge Rd.) 11th Election District; 5th Councilmanic District VAR -to allow pool in front yard in lieu of resr yard.

> 11/29/89 - Z.C.'s Order DENYING Petition. FRIDAY, JULY 13, 1990 at 10:00 a.m.

Counsel for Patitioners/Appellants cc: David S. Pearl, Esquire

Mr. and Mrs. Richard Johnson Mr. Barry Rider People's Counsel for Baltimore County P. David Fields Pat Keller

J. Robert Haines Ann M. Nastarowicz James E. Dyer W. Carl Richards, Jr. √Docket Clerk - Zoning

Arnold Jablon, County Attorney

Legal Secretary

LindaLee M. Kuszmaul

The Zonnig Communication, will, however, entertain thy request for a stay of the securing of send permit during the period for good cause shown. Such request must be in unting and received in the office by the date of the hearing out above or prescriber of the hearing.

NOTE:

(If "PHASE IS" of the "SNOW EMERGENCY FLAN" is in effect in Baltimon; County on the above hearing date, the Hearing will be postponed. In the event of snow, telephone 867-3301 to confirm hearing date.)

J. ROBERT HAINES

HOTICE OF HEARING

The Zoring Commissions of Ballerrore County, by sudromy of the Zoring Act and Requestors of Belterrore County will hold a public hearing on the property identified herein in Room 106 of the County Office Ruiding, to-celed at 111 W. Cheespeake Avenue in Towson, Maryland 21204 as follows:

Person for Zoreng Venence Case number: 90-164-A NS Forge Road, rear 167

West of and opposite Winter West of and opposite Winter

Zonvig Commissioner of Baltimore County NJ/10/196 Oct. 12.


## **CERTIFICATE OF PUBLICATION**

THIS IS TO CERTIFY, that the annexed advertisement was published ed in the NORTHEAST TIMES BOOSTER and the NORTHEAST TIMES REPORTER, weekly newspapers published in Paltimore County, Ma., once in each of successive weeks, the first publication appearing on Oct 12 1989

NORTHEAST TIMES BOOSTER and the NORTHEAST TIMES REPORTER

5. Zehe\_Orlon

PO 17274 reg, M34244 40-164-A rea\_ Avice \$ 93.57

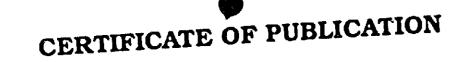


TOWSON, MD., Oct 13 1989 THIS IS TO CERTIFY, that the annexed advertisement was

published in THE JEFFERSONIAN, a weekly newspaper published in Towson, Baltimore County, Md., once in each of \_\_\_\_ successive weeks, the first publication appearing on Oct 12, 19 89.

THE JEFFERSONIAN.

PO 17274 reg M34244 co 90-164-A

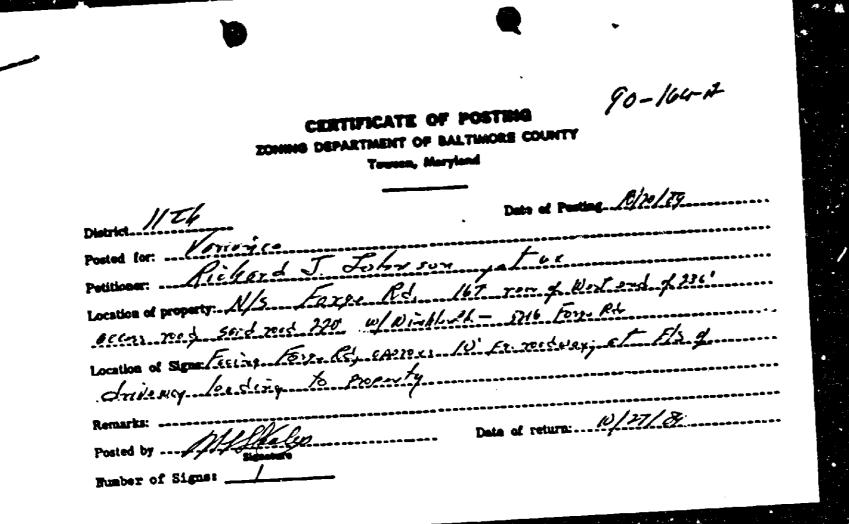

Baltimore County Zoning Commissioner
Office of Planning & Zoning Towson, Maryland 21204 (301) 887-3353

Mr. & Mrs. Richard J. Johnson

Perry Hall, Maryland 21143

5216 Forge Road

J. Robert Haines
Zoning Communicate DATE 10/17/89

Dennis F. Rasmussen County Executive Re: Petition for Zoning Variance CASE NUMBER: 90-164-A NS Forge Road, rear 167' West of end of 236' access road, such road being 220' West of and

opposite Winkler Road 5216 Forge Road 11th Election District - 5th Councilmanic Petitioner(s): Richard J. Johnson, et ux HEARING: THURSDAY, NOVEMBER 9, 1989 at 2:00 p.m.

Dear Mr. & Mrs. Johnson:

Please be advised that \$212.14 is due for advertising and posting of the above captioned property.

THIS FEE MUST BE PAID AND THE ZONING SIGN & POST SET(S) RETURNED ON THE DAY OF THE HEARING OR THE ORDER SHALL NOT ISSUE.

DO NOT REMOVE THE SIGN & POST SET(S) FROM THE PROPERTY

UNTIL THE DAY OF THE HEARING.

Please make your check payable to daltimore County, Maryland. Bring the check and the sign & post set(s) to the Zoning Office, County Office Building, 111 W. Chesapeake Avenue, Room 113, Towson, Maryland fifteen (15) minutes before your hearing is scheduled to begin.

Be advised that should you fail to return the sign & post set(s), there will be an additional \$50.00 added to the above amount for each such set not returned.

"SNOW EMERGENCY PLAN" is in effect in Baltimore County on the above hearing date, the Hearing will be postponed. In the event of snow, telephone 887-3391 to confirm hearing date.)

Baltimore County Zoning Commissioner
Office of Planning & Zoning
Towson, Maryland 21204
(301) 887-3353 J. Robert Haines Bests Commissioner October 23, 1989 Dennis F. Rasmusses County Executive BILLING CORRECTION Richard J. Johnson 5216 Forge Road Perry Hall, Maryland 21143 Re: Case Number: 90-164-A Petitioner(s): Richard J. Johnson, et ux Dear Petitioners: ard our prior billing dated October 17, 1989. The correct ising and posting charges for the above case is Baltimore County
Zoning Commission
County Office Building
Towson, Maryland 210 - returned and these charges paid on --- billing may recelled. - PUBLIC REFIRING FEES LAST HAME OF OWNER: JUHHOUN 8 096 \*\*\*\*\* 11857: a = 050F

Paltimore County
Zoning Commissioner
Office of Planning & Zont &
Townson, Maryland 21204
(301) 887-3383 J. Robert Haines Lawy Dannesser

NOTICE OF HEARING



The Zoning Commissioner of Baltimore County, by authority of the Zoning Act and Regulations of Baltimore County will hold a public hearing on the property identified herein in Room 108 of the County Office Building, located at 112 W. Chesapeake Avenue in Towson, Maryland as

Petition for Zoning Variance CASE NUMBER: 90-164-A

NS Force Soud, rear 167' West of end of 236' access road, such at a being 220' West of 5216 Forge Road 11th Election District - 5th Councilmanic

Petitioner(s): Richard J. Johnson, et ux HEARING: THURSDAY, NOVEMBER 9, 1989 at 2:00 p.m.


Variance: To allow an acressory structure (swimming pool) to be located in the front yard in lieu of the required year yard.

In the event that this Petition is granted, a building permit may be issued within the thirty (30) day appeal period. The Zoning Commissioner will, however, entertain any request for a stay of the issuance of said permit during this period for good cause shown. Such request must be in writing and received in this office by the data of the hearing set above or pre-

(If "PHASE II" of the "SNOW EMERGENCY PLAN" is in effect in Baltimore County on the above hearing date, the Hearing will be postponed. In the event of snow, telephone 887-3391 to

I. Robert Springe ZONING COMMISSIONER BALTIMORE COUNTY, MARYLAND

cc: Mr. & Mrs. Johnson J. A. Arkuszeski, Jr.

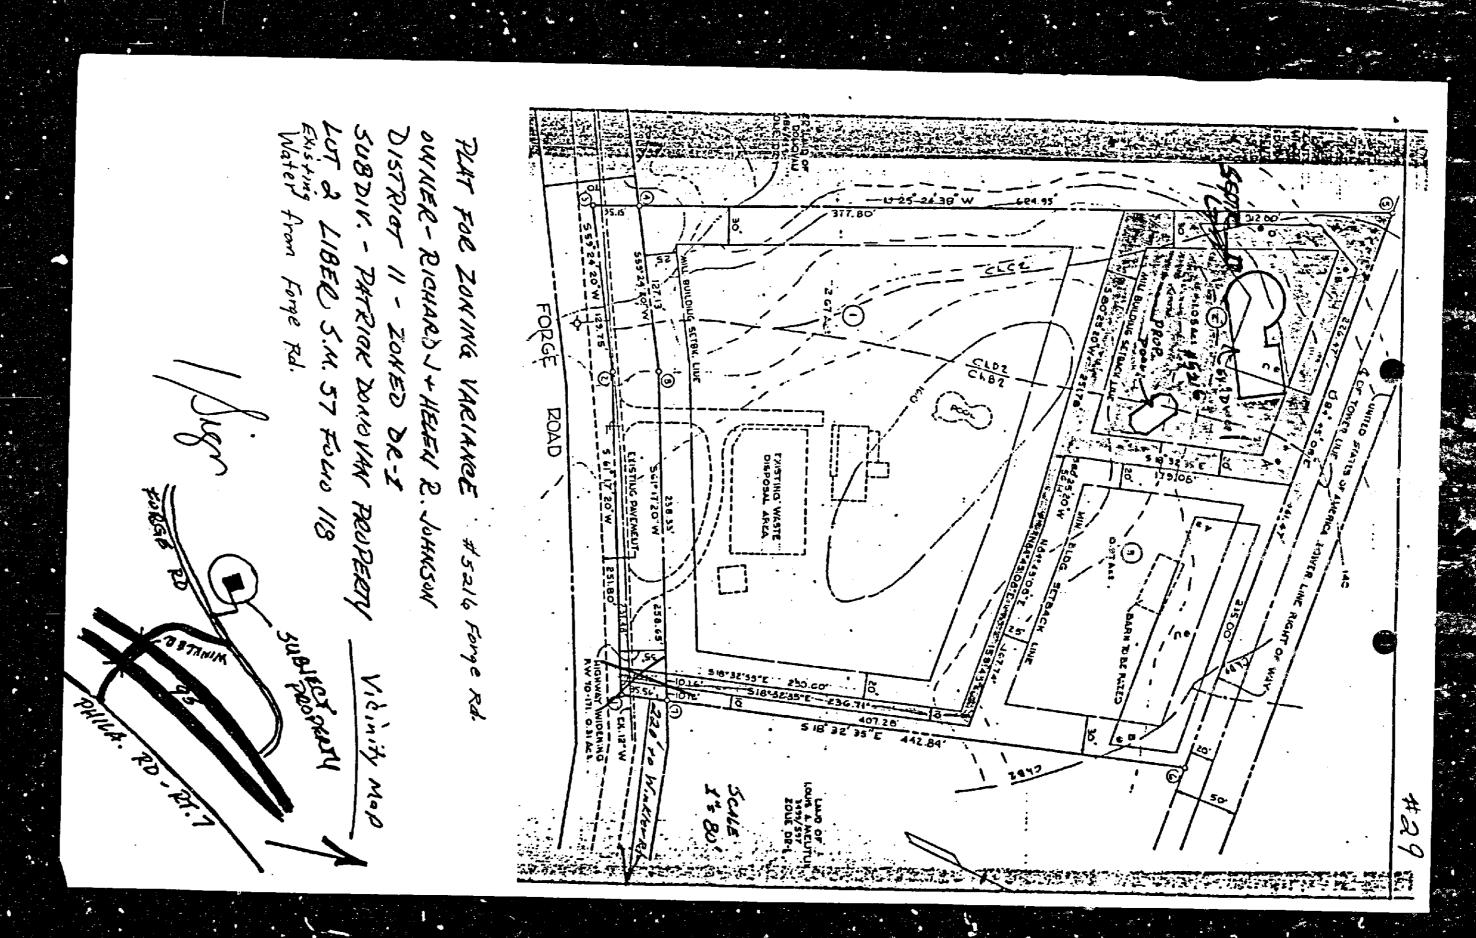

#### BALTIMORE COUNTY ZONING PLANS ADVISORY COMMITTEE

October 30, 1989

COUNTY OFFICE BLDG. 111 W. Chesapeake Ave. Towson, Maryland 21204

Burrau of

Department of

Bureau oi Fire Prevention

Health Department

Project Planning

Building Department

Board of Education

Zoning Administration

Industrial

Development

Mr. & Mrs. Richard J. Johnson
5216 Forge Road
PerryHall, ND 21148

RE: Item No. 29, Case No. 90-164-A
Petitioner: Richard J. Johnson
Petition for Zoning Variance

Dear Mr. & Mrs. Johnson:

The Zoning Plans Advisory Committee has reviewed the plans submitted with the above referenced petition. The following comments are not intende to indicate the appropriateness of the zoning action reques ed, but to assure that all parties are made aware of plans or problems with regard to the development plans that may have a bearing on this case. Director of plans may file a written report with the Zoning Commissioner Planning may file a written report with the zoning the requested zoning.

Enclosed are all comments submitted from the members of the Committee at this time that offer or request information on your petition. If similar comments from the remaining members are received, I will forward them to you. Otherwise, any comment that is not informative will be placed in the hearing file. This petition was accepted for filing on the date of the enclosed filing certificate and a hearing scheduled accordingly.

IT WOULD BE APPRECIATED IF YOU WOULD RETURN YOUR WRITTEN COMMENTS TO MY OFFICE, ATTENTION JULIE WINIARSKI. IF YOU HAVE ANY QUESTIONS REGARDING THIS, PLEASE CONTACT HER AT 887-3391.

Grand S

Chairman
Zoning Plans Advisory Committee

JED:jw

Enclosures

cc: Mr. J. A. Arkuszeski, Jr. 1131 Engelberth Road Baltimore, MD 21221 Baltimore County
Zoning Commissioner
Office of Planning & Zoning
Towson, Maryland 21204
(301) 887-3353
J. Robert Haines
Zoning Commissioner



Your petition has been received and accepted for filing this 9th day of August, 1989.

J. Robert Haines
ZONING COMMISSIONER

J. ROBERT HAINES
ZONING COMMISSIONER

Received By:

Chairman,
Zoning Plans Advisory Committee

Petitioner's Attorney:

NAV. 9

# BALTIMORE COUNTY, MARYLAND INTER-OFFICE CORRESPONDENCE

TO: J. Robert Haines
Zoning Commissioner

DATE: October 31, 1989

FROM: Pat Keller, Deputy Director
Office of Planning and Zoning

SUBJECT: Richard Johnson, Item 29 Zoning Petition No. 90-164

The Petitioner requests a Variance to allow an accessory structure to be located in the front yard in lieu of the required rear yard.

- In reference to this request, Staff offers the following comments:
- The Petitioner should erect a fence in compliance with Section 427 of the B.C.Z.R.
- Plant screening shall be provided along the property line adjacent to Lot 3.
- Plans should be submitted to the Baltimore County Landscape
   Planner for review prior to any improvement of the property.
- If there should be any further questions or if this office can provide additional information, please contact Jeffrey Long in the Office of Planning at 887-3211.

PK:JL:ggl ZP90/164

11/1/89 sent in mail jew. NOV 0 1 1989

Baltimore County
Department of Public Works
Bureau of Traffic Engineering
Courts Building, Suite 405
Towson, Maryland 21204
(301) 887-3554



ZONING OFFICE

August 25, 1989

Dennis F. Rasmu Crusty Em

Mr. J. Robert Haines Zoning Commissioner County Office Building Towson, Maryland 21204

Dear Mr. Haines:

The Bureau of Traffic Engineering has no comments for items number 25, 27, 28, 129 30, 31, 32, 33, 34, 35, 36, 38, 39, 40, 41, and 42.

Very truly yours,

Michael S. Flanigan
Traffic Engineer Associate II

MSF/lvw

Baltimore County
Fire Department
800 York Road
Towson, Maryiand 21204-2586
(301) 887-4500

AUGUST 11, 1989



J. Robert Haines
Zoning Commissioner
Office of Planning and Zoning
Baltimore County Office Building
Towson, MD 21204

RE: Property Owner: R

RICHARD J. JOHNSON

Location: #5216 FORGE ROAD

Item No.: 29

Zoning Agenda: AUGUST 8, 1989

Pursuant to your request, the referenced property has been surveyed by this Bureau and the comments below are applicable and required to be corrected or incorporated into the final plans for the property.

7. The Fire Prevention Bureau has no comments at this time.


REVIEWER: A log filly 5-11-11 Approved Fire Prevention Bureau


Special Inspection Division


JK/KEK


AUG 1 6 1990



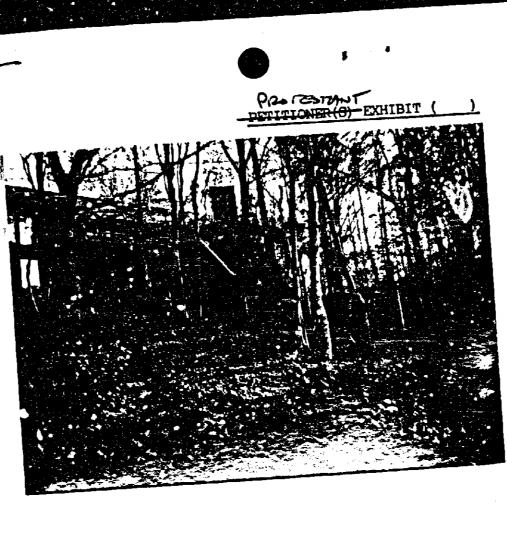

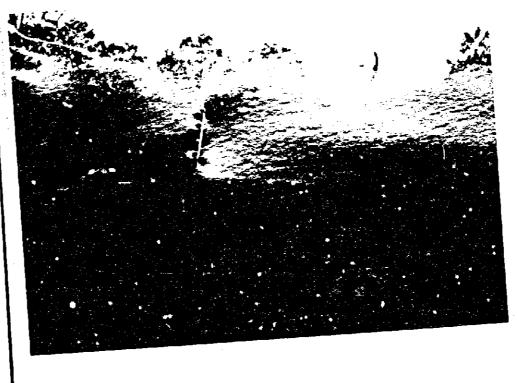

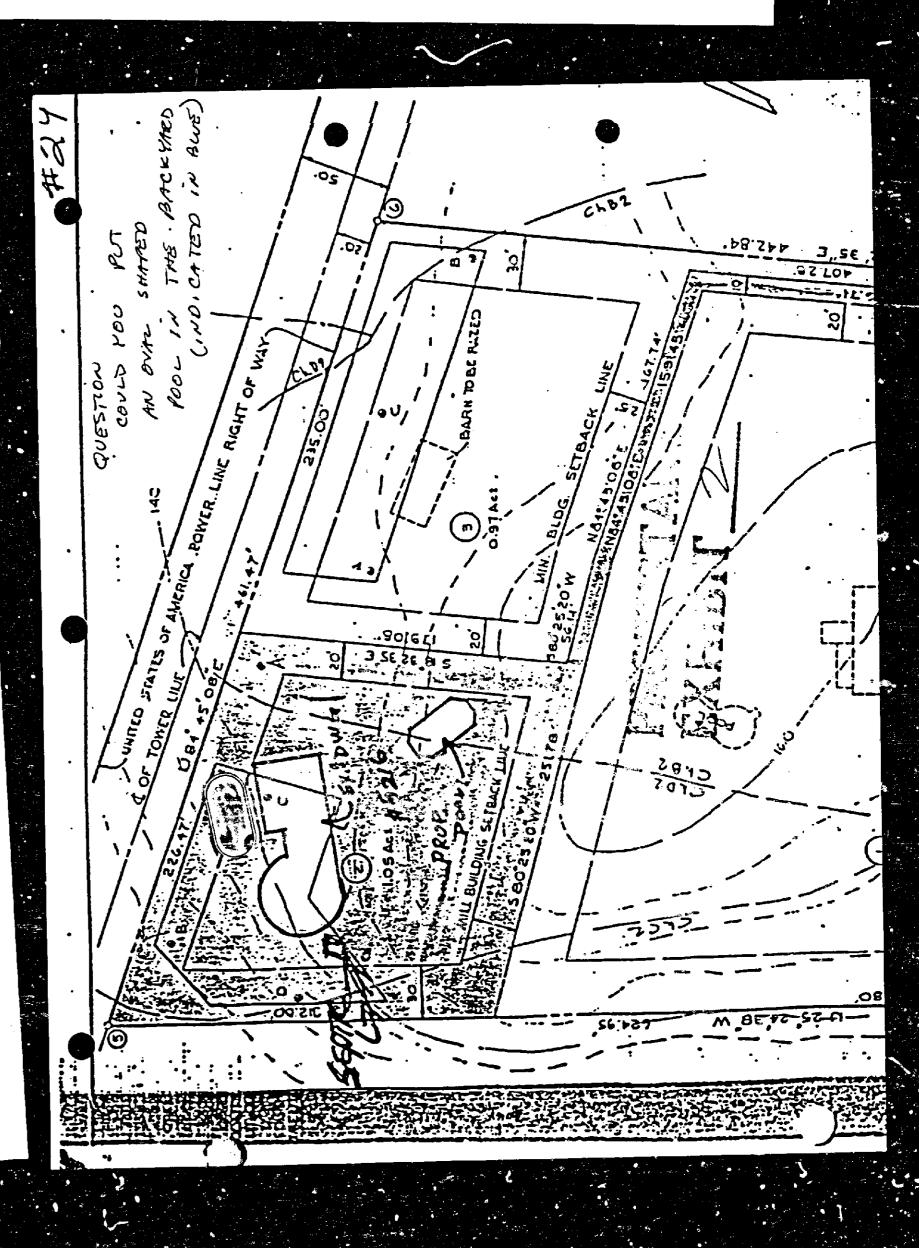

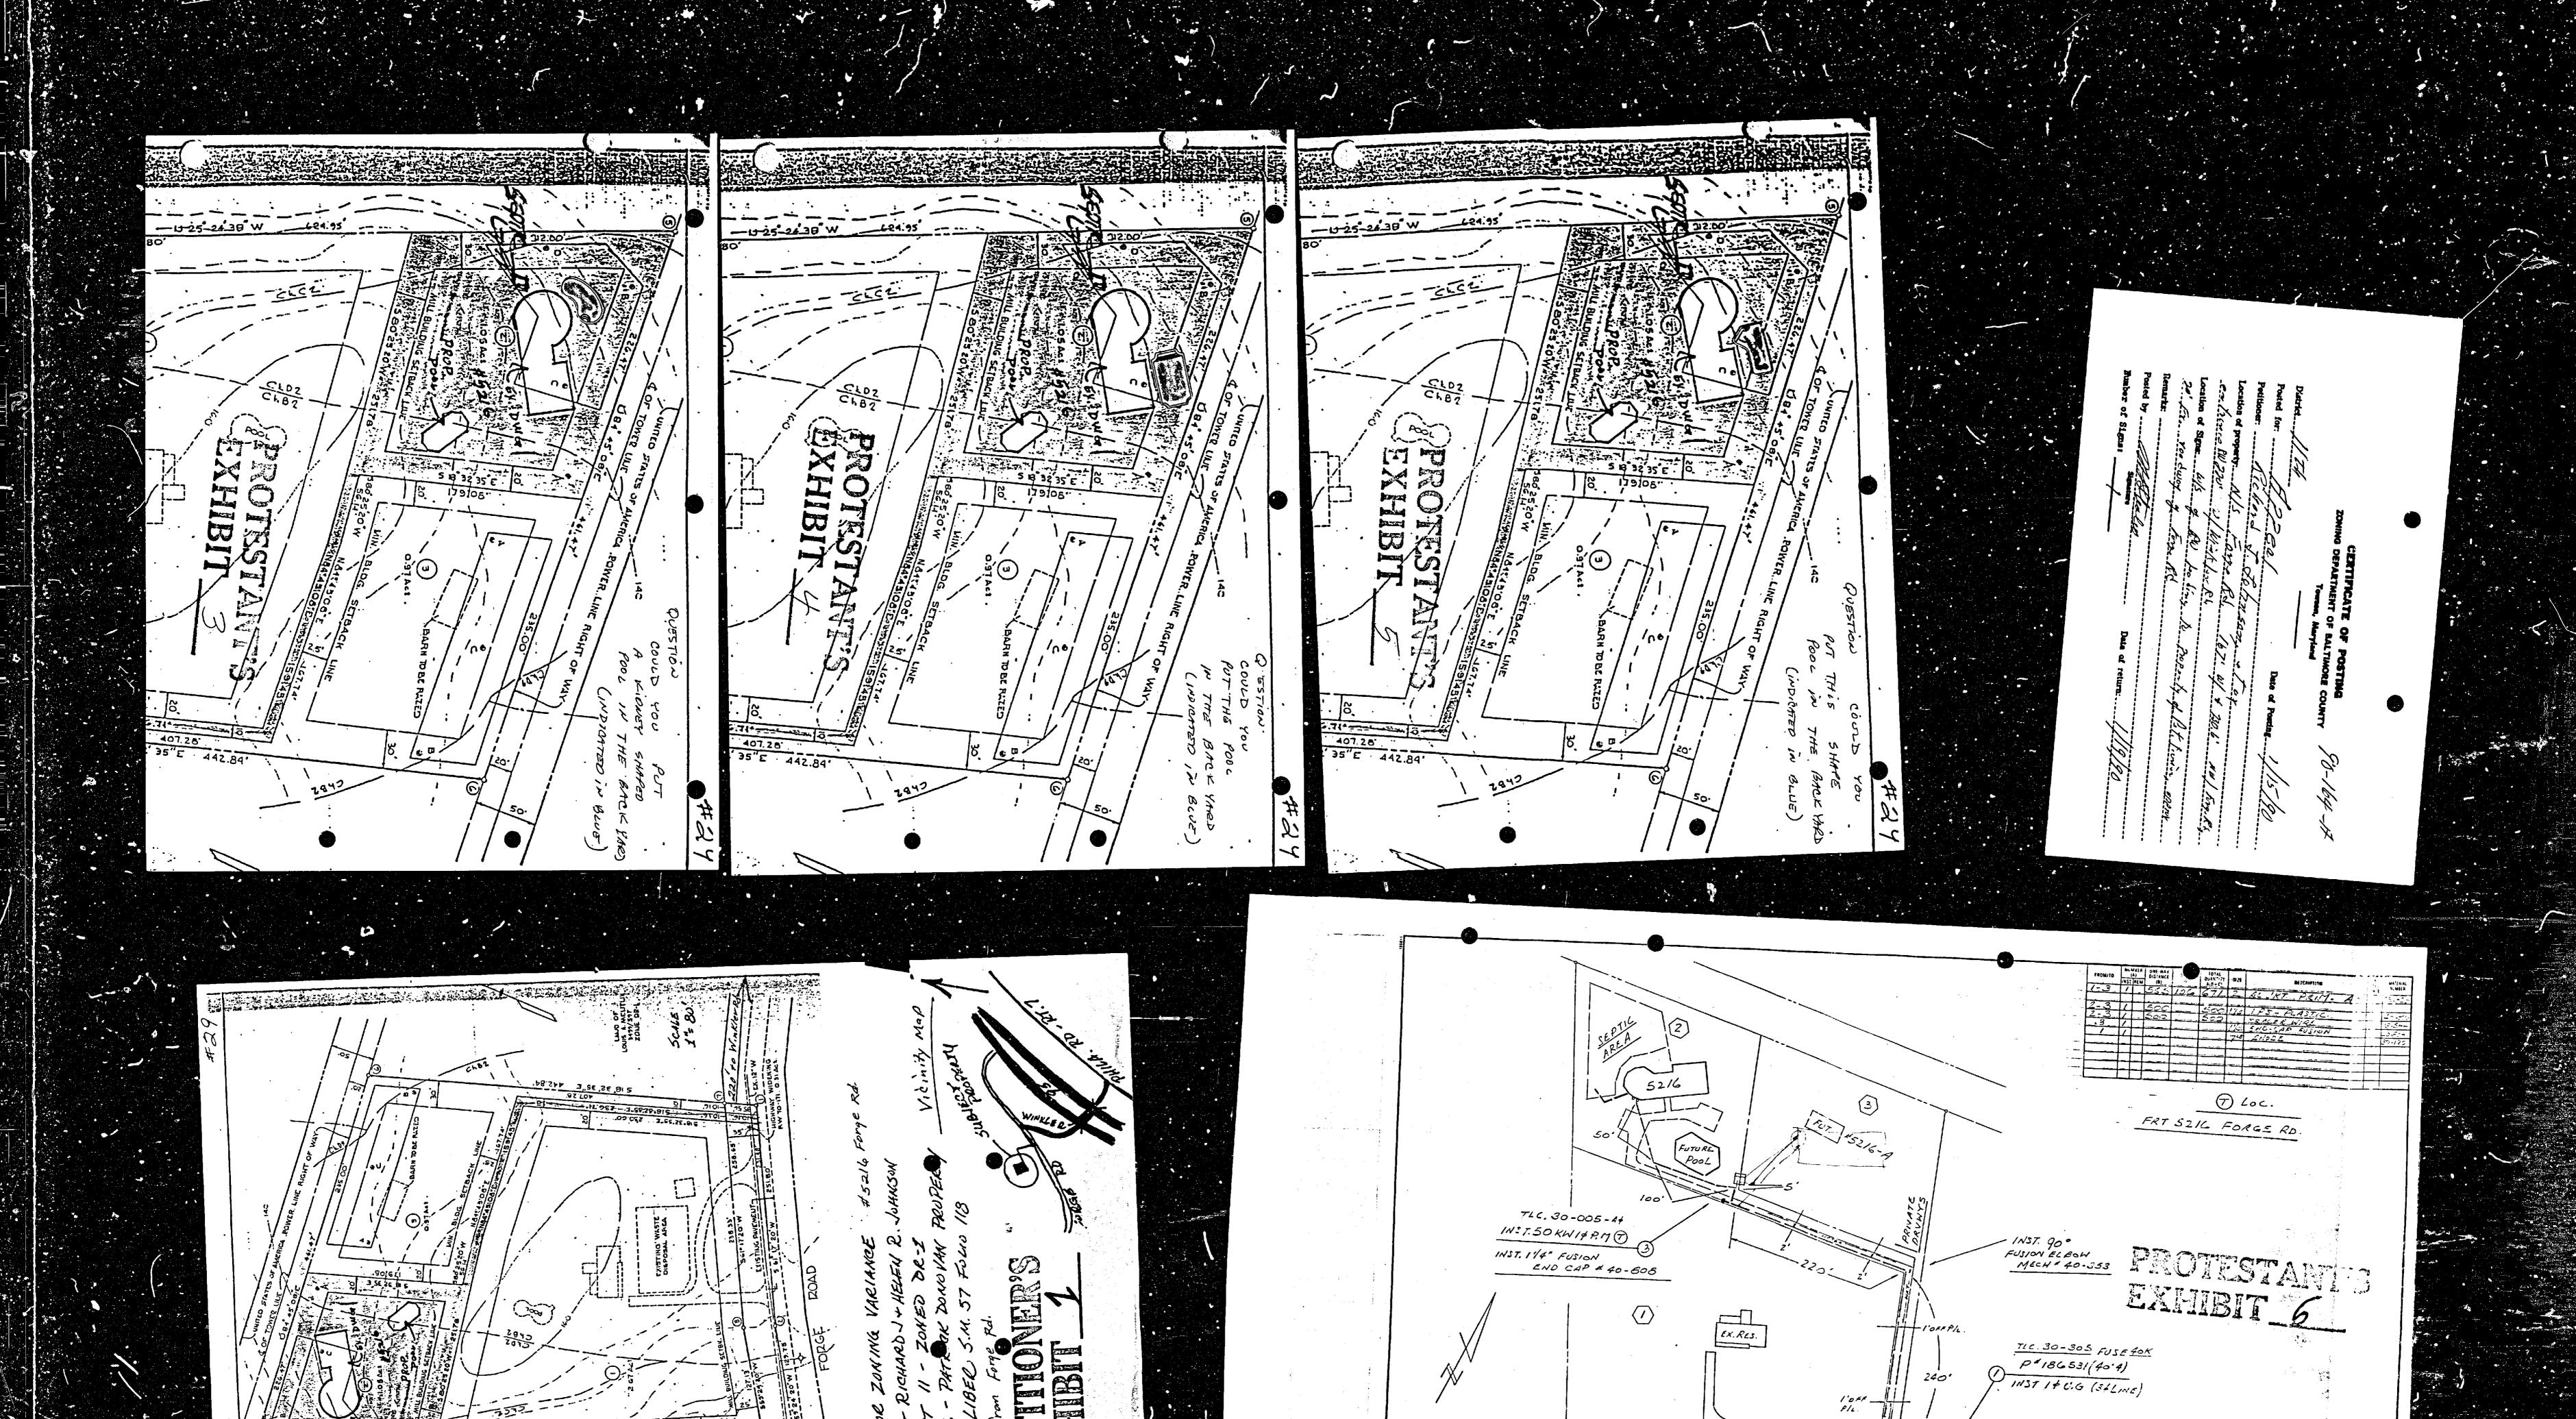

SERVICE INFO

2-410 AL & 210 N (23-221) 300' GAS CERVICE 5/8 FL 11: TAR 7/24 RE RE 150' - + + 0-545 30001 E TERES A

BALTO. CO. FERMITE APP. FOR 2-2-87

ARRIVATION OF SECOND

LOCATION OF SAS SELECTRIC FACRITIES APPROPRIES


RINTOFOLLOW

AM INST MY TUCKER FAM.

GAS MAIN EXT. (2)
UNCOVER EX. Z" MAIN
INST. 1-17 LB ANODE
" 2" STL. TO 1'14" LAT.
ASSET. # 203.302.30